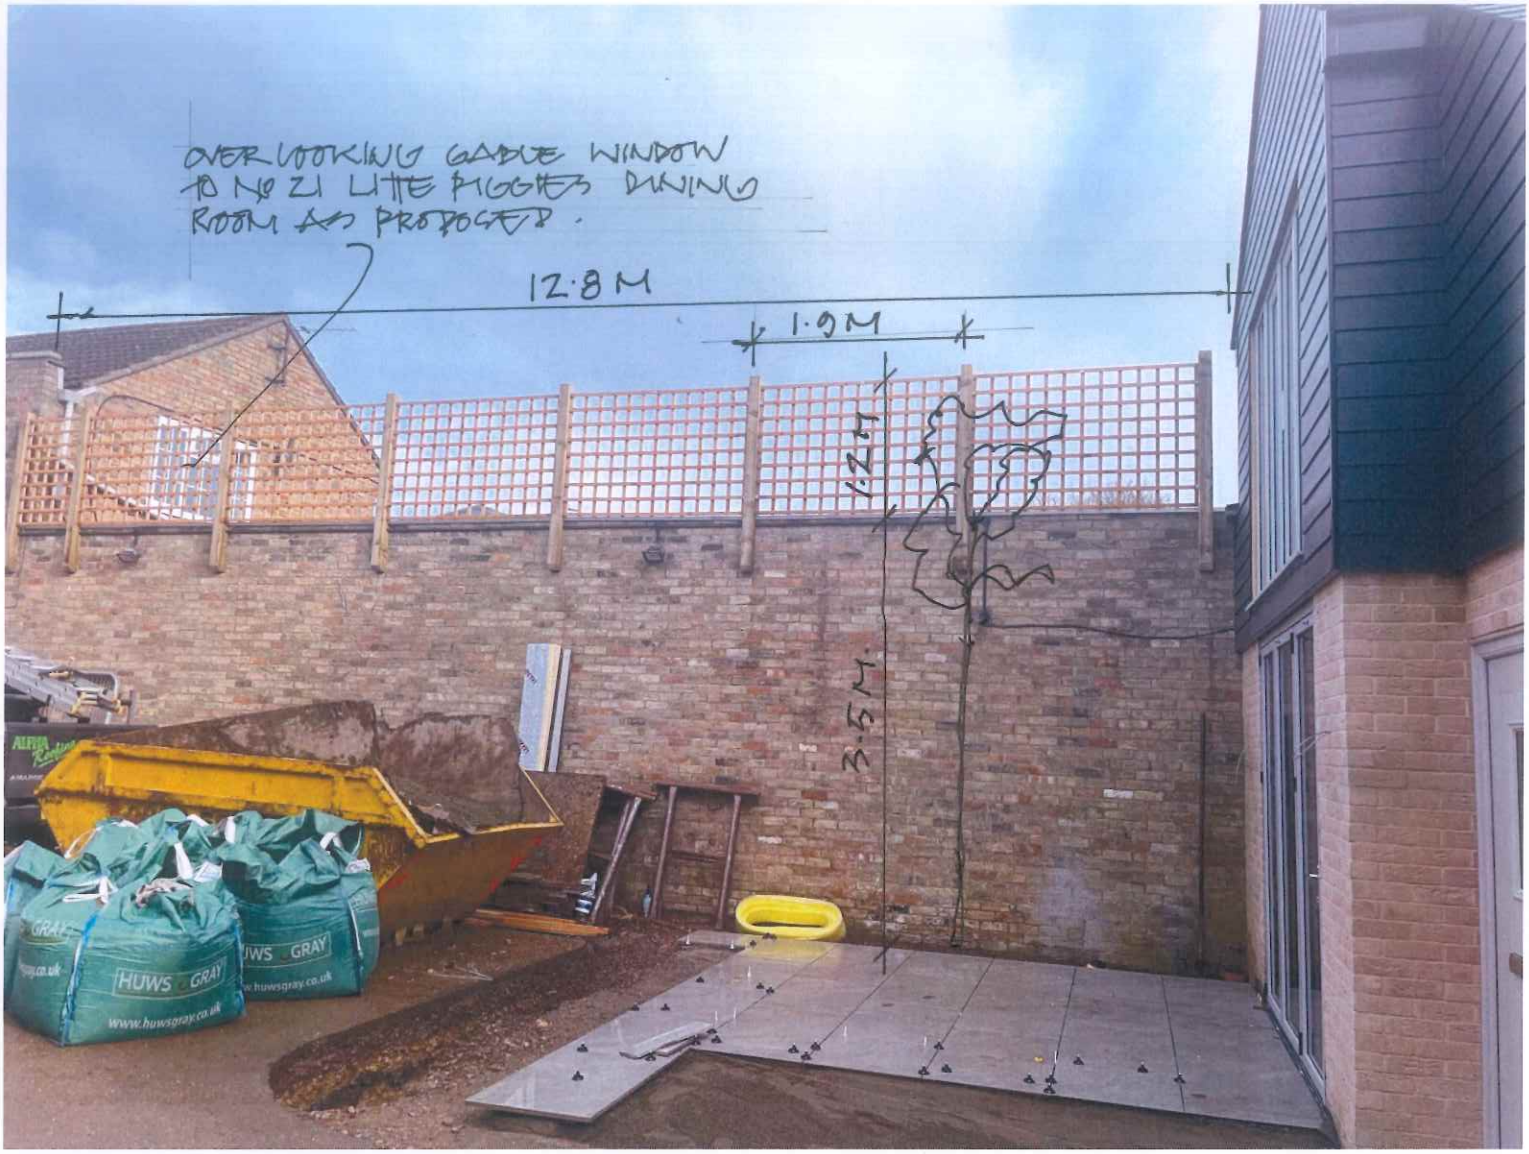


FUTURE EVERGREEN PLANTING TO BOUNDARY WALL.

Photo of Trellis as installed to Neighbours wall with dimensions & Notes.

For J Wilks @ No 19 High Street, Fenstanton, PE28 9JX

Date 14 March 2025

Scales NA

PITTS ARCHITECTS
4 Sutherland Cottages, London Street
Brancaster, Norfolk, PE31 8AS
01485 210365 david@pittsarchitects.co.uk. REV No:

DRG No: 1494.08