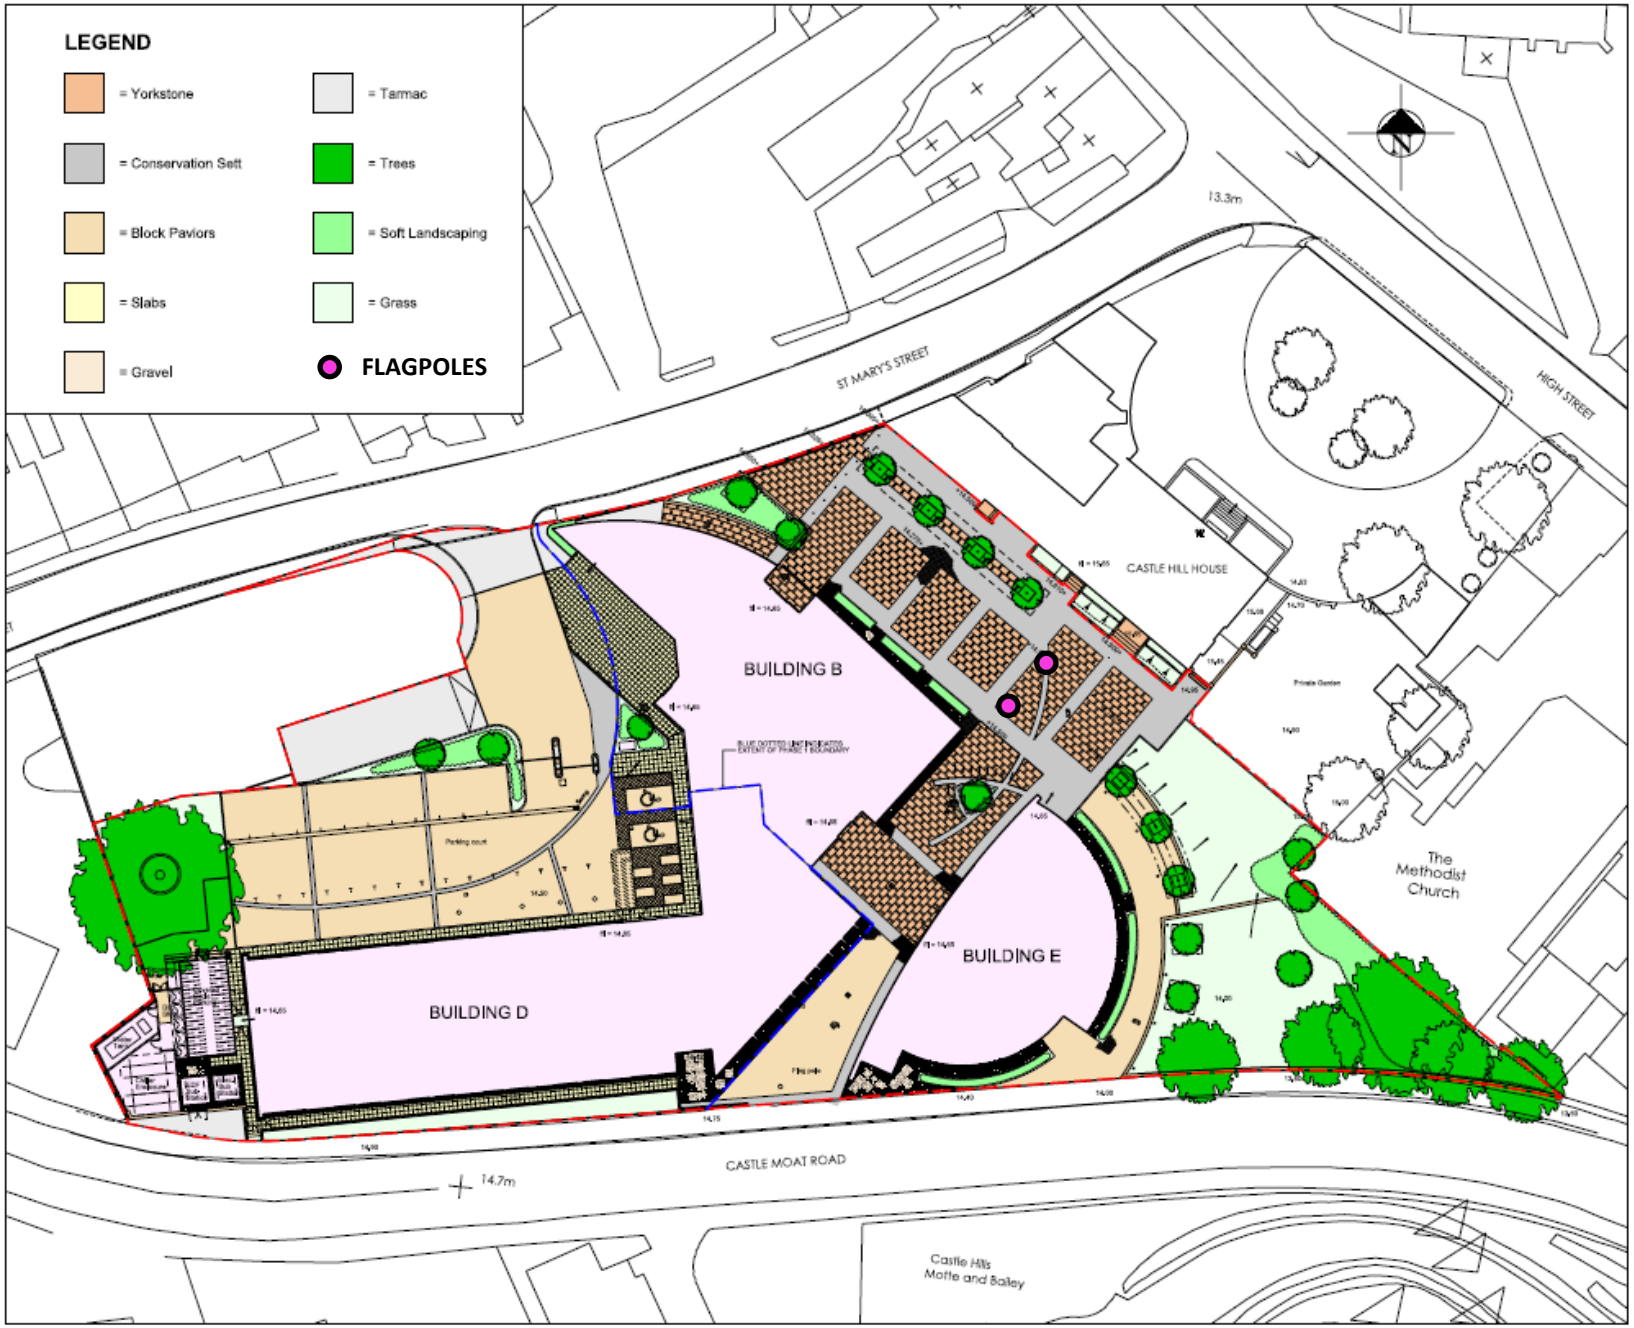

AS BUILT

The information shown on this drawing reflects details originally incorporated or varied by Archial Architects and only such other variations as have been advised to them by other parties. Archial Architects cannot guarantee that such detail shown has been verified by.

Rev	Date	Details	Drawn	Checked
P	04/06/18	AMENDED IN LINE WITH CONSTRUCTIONS COMMENTS	DB	EDS
H	15/05/18	DRAWING AMENDED TO AS BUILT.	DB	EDS
M	18/12/08	KERBLINE ADJACENT TO BUILDING A AMENDED.	CC	EDS
L	25/21/08	DRAWING AMENDED TO AS BUILT - PHASE 1	EDS	SC
K	17/12/08	CYCLE STORE, HARD & SOFT LANDSCAPING REVISED	EDS	SC
J	19/09/08	CHILLER ENCLOSURE AMENDED	EDS	SC
H	05/21/08	PLANTER BY HAMMERHEAD INDICATED	EDS	SC
G	31/12/07	CORE AMENDED TO SHOW STUDWORK	CC	SC
F	25/12/07	AMENDED SITE BOUNDARY TO UPDATED LAYOUT	MA	SC
E	04/09/07	AMENDED SITE BOUNDARY TO UPDATED LAYOUT	MA	SC
D	12/12/08	ENTRANCE DOORS TO BUILDINGS C AND E AMENDED	MA	SC
C	27/09/08	REPOSITION LAYOUT, IN BUILDING D	MA	SC
B	29/09/08	REDESIGN LANDSCAPE TO FOLLOW DA CONCEPT	MA	SC
A	20/09/08	BUILDING A REDUCED TO TARGET FLOOR AREA	MA	SC

Issued for:
AS BUILT

Project/Client: HUNTINGDON DISTRICT COUNCIL	Project No: 05093
CARILLION	Dwg No: 1601
	Rev: P
Drawing: SITE LAYOUT PLAN	Scale: 1:250 @A1
	Drawn By: FB Date: 04.08.06
	Checked By: SC Date: 04.08.06

archial

Brook Hall, Brook Street, Warwick, CV34 4BL
T: +44 (0)1926 492323 F: +44 (0)1926 496316
www.archialgroup.com

© Archial Architects Ltd. Contractors must work to figured dimensions which are to be checked on site.
Registered Office • Hampton House, 104 • 106 Great Portland Street, London W1W 6PQ Registered Number • 3707181