
NOTES

1. Contractors must check all dimensions on site. Only figured dimensions are to be worked from. Discrepancies must be reported to the Architect or Engineer before proceeding. © This drawing is copyright.

2. Reproduced from OS Sitemap ® by permission of Ordnance Survey on behalf of The Controller of Her Majesty's Stationery Office. © Crown copyright 2008. All rights reserved. Licence number 100007126.

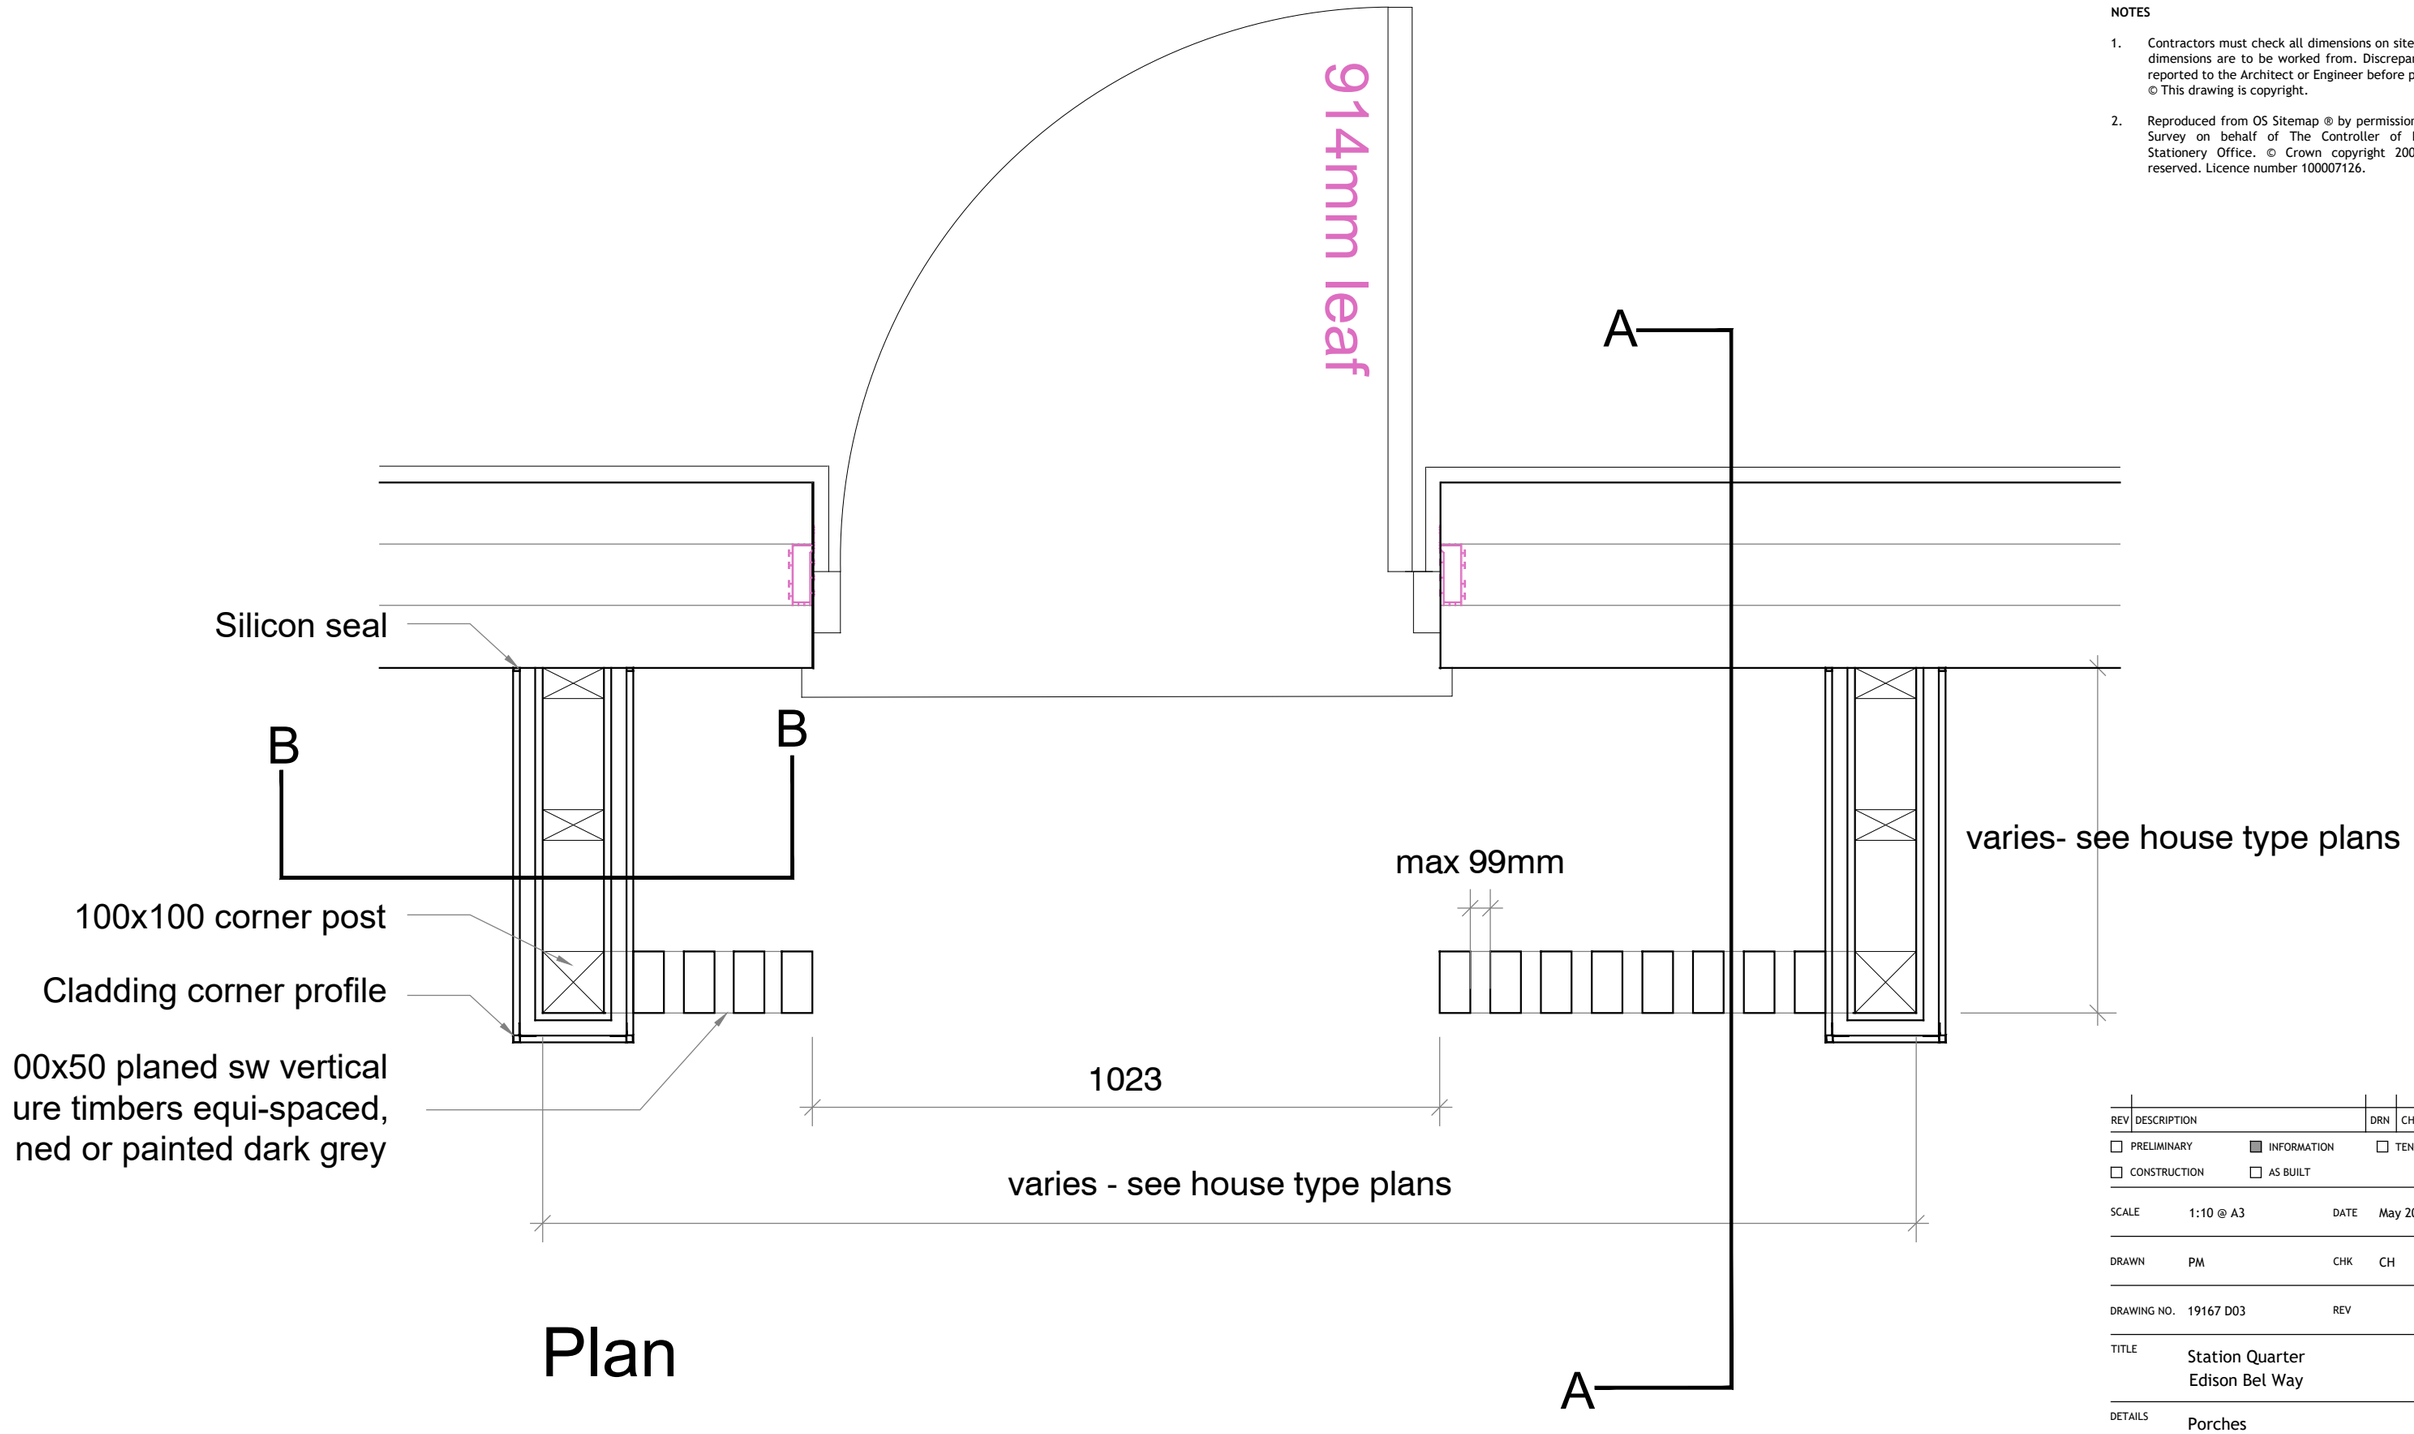

Plan


REV	DESCRIPTION	DRN	CHD	DATE

☐ PRELIMINARY ■ INFORMATION ☐ TENDER

☐ CONSTRUCTION ☐ AS BUILT

SCALE	1:10 @ A3	DATE	May 2024
DRAWN	PM	CHK	CH
DRAWING NO.	19167 D03	REV	
TITLE	Station Quarter Edison Bel Way		
DETAILS	Porches		

Woods Hardwick
Architecture | Engineering | Planning | Surveying

BEDFORD : HEAD OFFICE
15-17 Goldington Road
Bedford MK40 3NH
T: +44 (0) 1234 268862

BIRMINGHAM
Fort Dunlop, Fort Parkway
Birmingham B24 9FE
T: +44 (0) 121 6297784

ONLINE: mail@woodshardwick.com | woodshardwick.com

PLEASE CONSIDER THE ENVIRONMENT BEFORE PRINTING THIS DRAWING