[redacted]

**From:** .box.Cadent.PlanningApplications <Cadent.PlanningApplications@cadentgas.com>
**Sent:** 22 January 2025 15:36
**To:** Control, Development (Planning)
**Subject:** LSBUD Ref: 36053772 Your Ref: 25/00051/HHFUL (SO) DBYD MP-LP High Risk
**Attachments:** We sent you safe versions of your files; 36053772_CadentGas.pdf

**Categories:** [redacted]

Mimecast Attachment Protection has deemed this file to be safe, but always exercise caution when opening files.

---

Date: 22/01/2025
LinesearchbeforeUdig ref: 36053772
Your ref: 25/00051/HHFUL (SO)

Dear Sir/Madam,

**Your planning application – No objection, informative note required**

We have received a notification from the LinesearchbeforeUdig (LSBUD) platform regarding a planning application that has been submitted which is in close proximity to our medium and low pressure assets. We have no objection to this proposal from a planning perspective, however we need you to take the following action.

**What you need to do**

To prevent damage to our assets or interference with our rights, please add the following **Informative Note** into the **Decision Notice:**

*Cadent Gas Ltd own and operate the gas infrastructure within the area of your development. There may be a legal interest (easements and other rights) in the land that restrict activity in proximity to Cadent assets in private land. The applicant must ensure that the proposed works do not infringe on legal rights of access and or restrictive covenants that exist.*

*If buildings or structures are proposed directly above the apparatus the development may only take place following diversion of the apparatus. The applicant should apply online to have apparatus diverted in advance of any works, by visiting cadentgas.com/diversions*

*Prior to carrying out works, including the construction of access points, please register on www.linesearchbeforeudig.co.uk to submit details of the planned works for review, ensuring requirements are adhered to.*

**Your responsibilities and obligations**

Cadent may have a Deed of Easement on the pipeline, which provides us with a right of access for a number of functions and prevents change to existing ground levels, storage of materials. It also prevents the erection of permanent/temporary buildings, or structures. If necessary Cadent will take action to legally enforce the terms of the easement.

This letter does not constitute any formal agreement or consent for any proposed development work either generally or related to Cadent's easements or other rights, or any planning or building regulations applications.

Cadent Gas Ltd or their agents, servants or contractors do not accept any liability for any losses arising under or in connection with this information. This limit on liability applies to all and any claims in contract, tort (including negligence), misrepresentation (excluding fraudulent misrepresentation), breach of statutory duty or otherwise. This limit on liability does not exclude or restrict liability where prohibited by the law nor does it supersede the express terms of any related agreements.

If you need any further information or have any questions about the outcome, please contact us at plantprotection@cadentgas.com or on 0800 688 588 quoting your reference at the top of this letter.

**Kind Regards,**
Plant Protection Team
T: 0800 688 588
plantprotection@cadentgas.com
cadentgas.com



---

This e-mail, and any attachments are strictly confidential and intended for the addressee(s) only. The content may also contain legal, professional or other privileged information. If you are not the intended recipient, please notify the sender immediately and then delete the e-mail and any attachments. You should not disclose, copy or take any action in reliance on this transmission.

Please ensure you have adequate virus protection before you open or detach any documents from this transmission. Cadent Gas Limited does not accept any liability for viruses. An e-mail reply to this address may be subject to monitoring for operational reasons or lawful business practices.

**Cadent Gas Limited is a limited liability company, registered in England and Wales (registered no. 10080864) with its registered office at Pilot Way, Ansty Park, Coventry, CV7 9JU.**

---

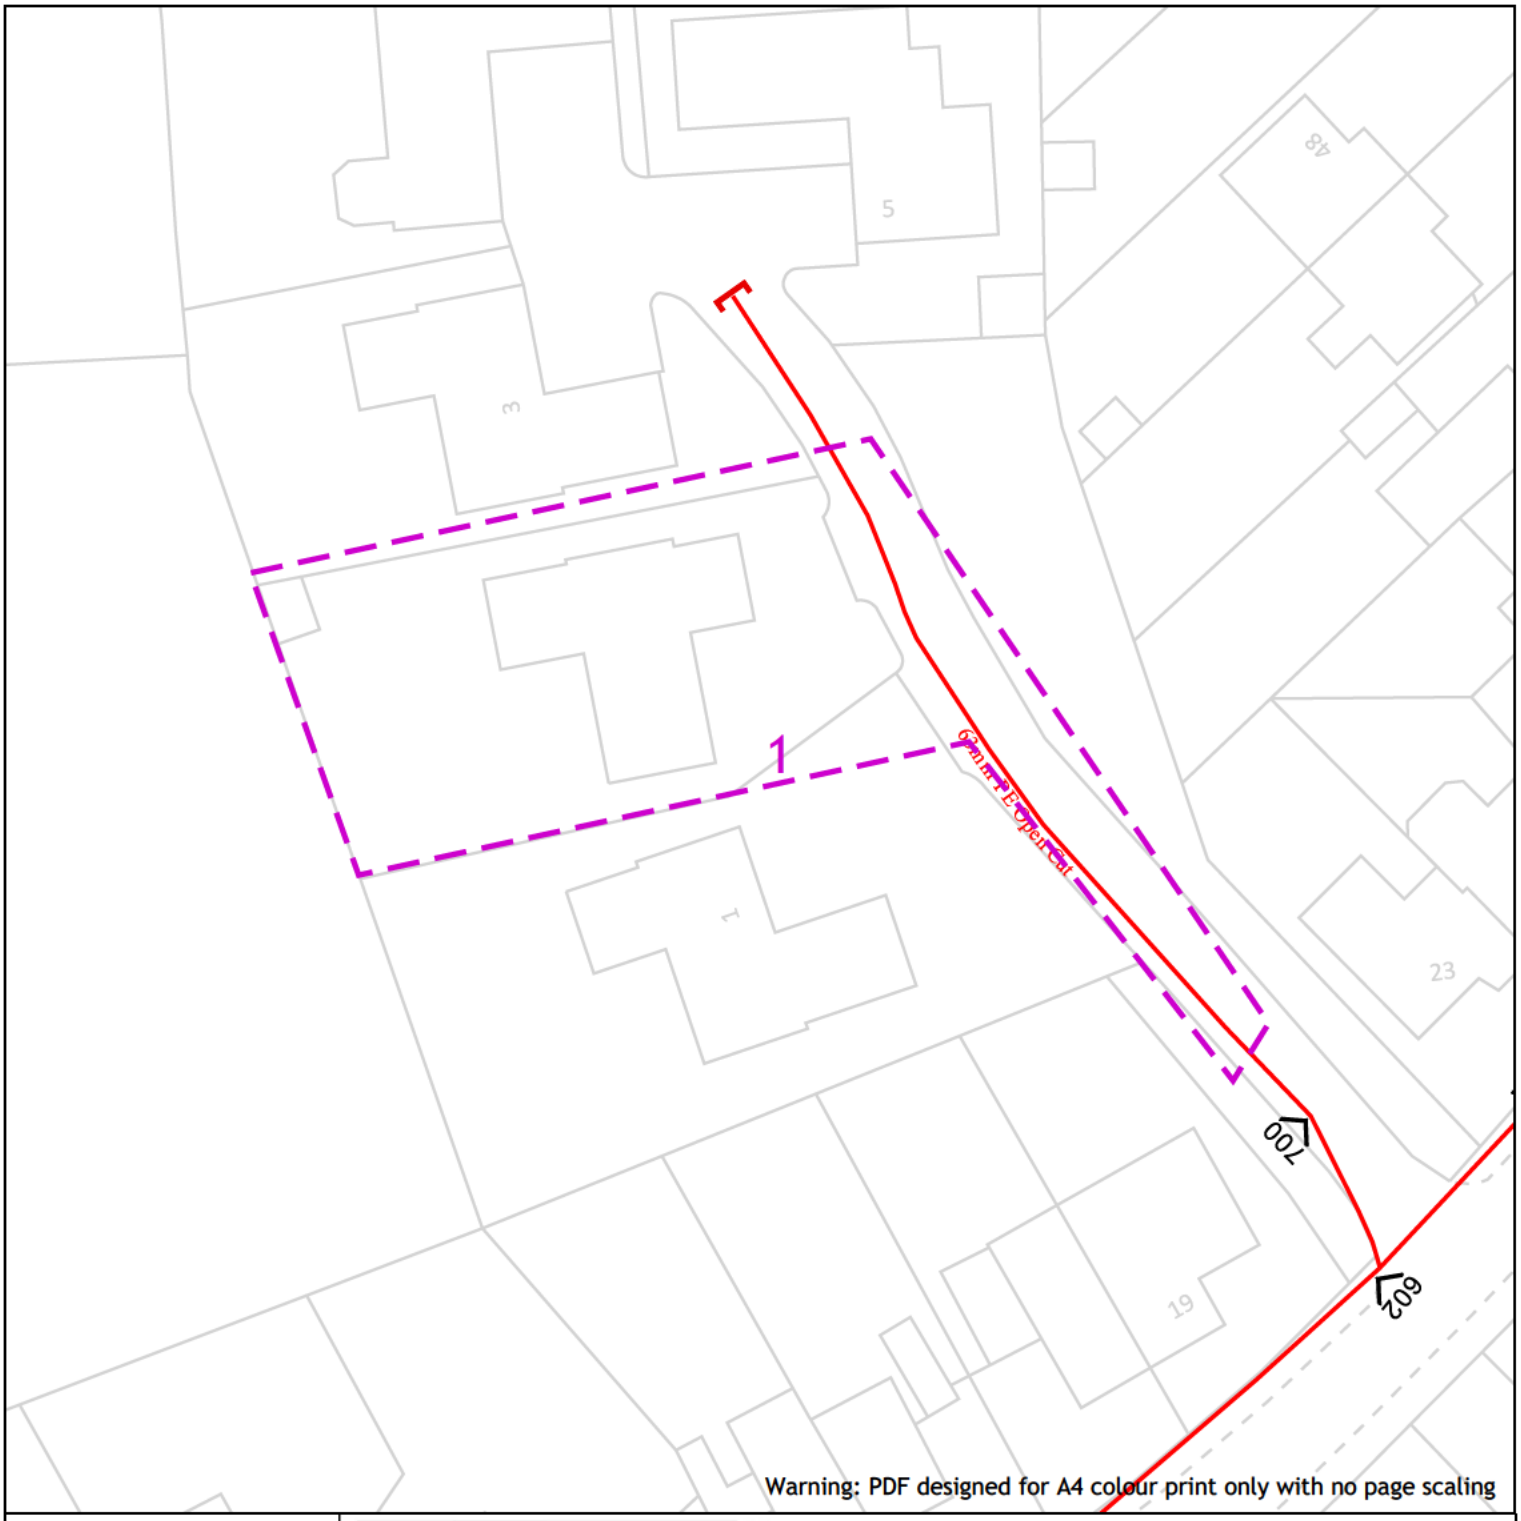


Warning: PDF designed for A4 colour print only with no page scaling

25m

Dig Sites Area: Line:

LP Mains
MP Mains
IP Mains
LHP Mains

Valve
Depth of cover
Syphon
Diameter Change
Material Change
Out of Standard Service

Where an out-of-standard service is present please contact plant protection 0800 688 588 for further information.
Out-of-standard service symbology may be used to indicate one or more of the following:
- Identification of shallow services
- Identification of dual services
- Recording of non-perpendicular services

A perpendicular service/connection is laid in a straight line from the entry point at the property to the connection at the main – this includes a pipe that has a perpendicular connection and is not straight but does not deviate more than 1m off centre line.

Cadent
Your Gas Network

Date Requested: 22/01/2025
Job Reference: 36053772
Site Location: 519363 267447
Requested by: [redacted]

Your Scheme/Reference:
25/00051/HHFUL (SO)

View extent: 100m, 100m

Scale: 1:500 (When plotted at A4)

IMPORTANT NOTICES

This plan shows these pipes owned by Cadent Gas Limited in its role as a Licensed Gas Transporter (GT). Gas pipes owned by other GT's or otherwise privately owned may be present in this area. Information with regards to such pipes should be obtained from the relevant owners. The information shown on this plan is given without warranty, the accuracy thereof cannot be guaranteed. Service pipes, valves, syphons, stub connections etc. are not shown but their presence should be anticipated. No liability of any kind whatsoever is accepted by Cadent Gas Limited or their agents, servants or contractors for any errors or omission. Safe digging practices, in accordance with HS(G)47, must be used to verify and establish the actual position of mains, pipes, services and other apparatus on site before any mechanical plant is used. It is your responsibility to ensure that this information is provided to all persons (either direct labour or contractors) working for you on or near gas apparatus. The information included on this plan should not be referred to beyond a period of 28 days from the date of issue.

**In case of emergency call - 0800 111 999**

Crown Copyright © This plan is reproduced from or based on the OS map by Cadent Gas Limited, with the sanction of the controller of HM Stationary Office. Crown Copyright Reserved. Ordnance Survey Licence number 100024886